View 58-20_2024 Model (2).pdf
1 page
Inspector Zoom Share Highlight Rotate Markup Form Filling Search...

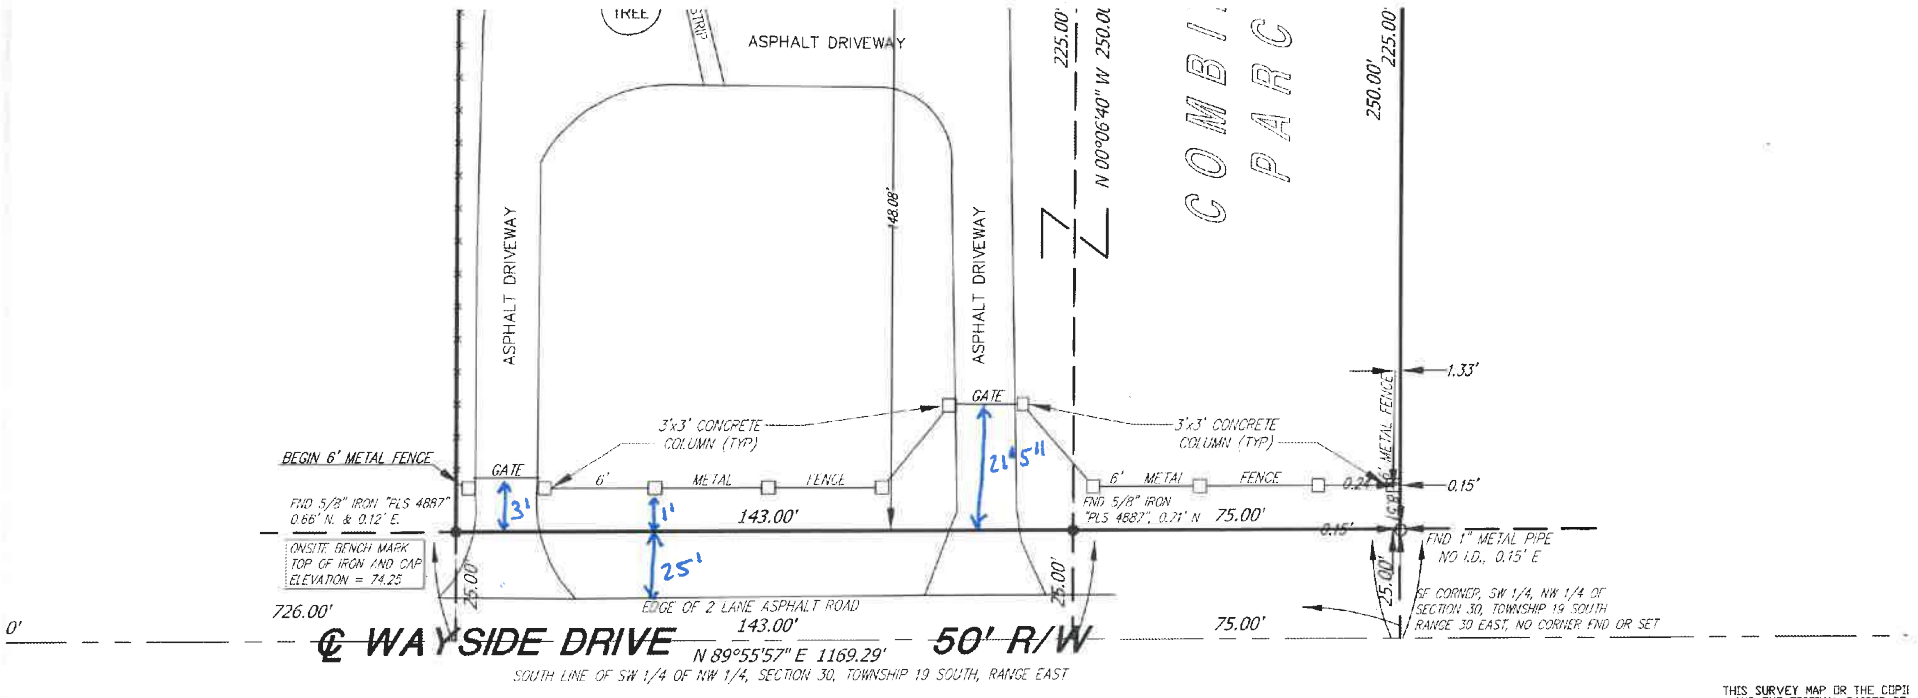

THIS SURVEY MAP OR THE COPI
AND THE ORIGINAL RAISED SE
ADDITIONS OR DELETIONS TO SURVEY
PARTIES IS PROHIBITED WITHOUT TH
THIS SURVEY IS PREPARED FOR TH

0' 30' 60' 90'

SCALE: 1" = 30'

		REVISIONS:	DATE:
FIELD:	J.R.L.		
TECHNICIAN:	D.A.D.		
COMP. FILE:	58-20_2024.CRD		
DRAFT FILE:	58-20_2024.DWG		
CHECKED BY:	A.F.D.		

DOUDNEY COMPANIES, INC., Florid
By: David A. Doudney, Presi
Field Date: 19 NOV. 2020
PAGE